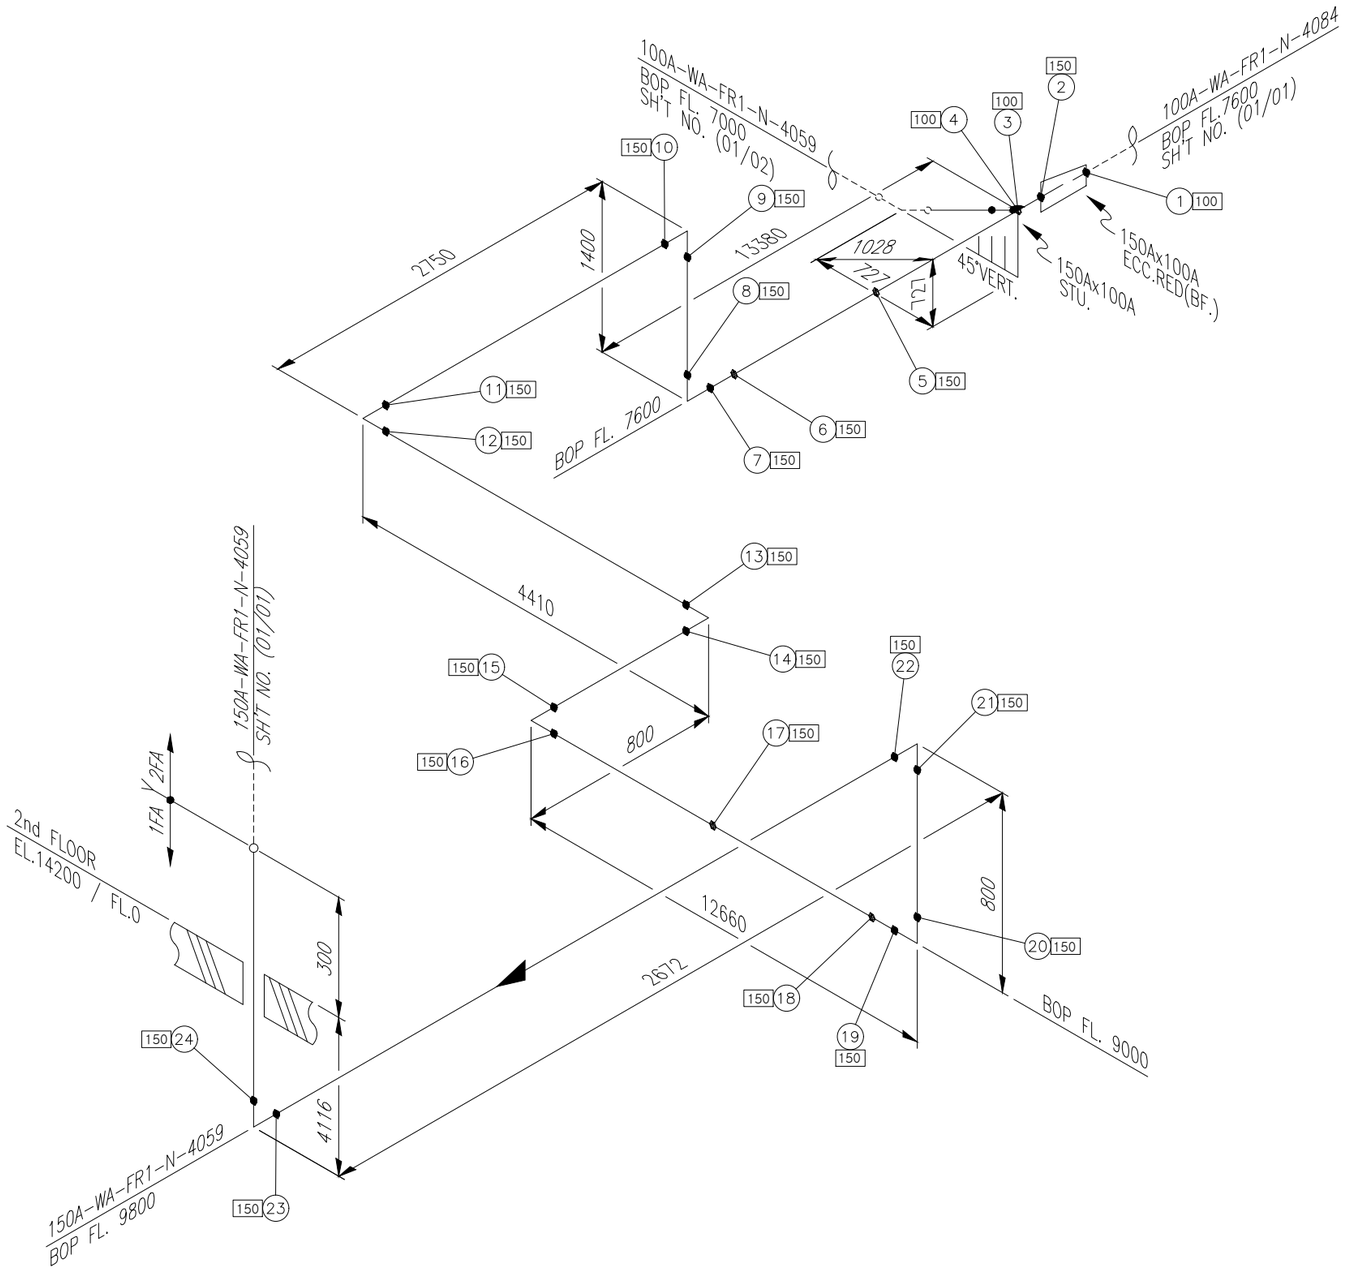



| ITEM | SIZE | Q'TY | DESCRIPTION |
|---|---|---|---|
| | | FR1 | |
| P | 150A | 44.1M | PIPE, FRP(MANUFACTURER STD), PE/BUTT-JOINT, 3.2T |
| P | 100A | 1.5M | PIPE, FRP(MANUFACTURER STD), PE/BUTT-JOINT, 3.2T |
| E90 | 150A | 8EA | ELBOW 90 DEG, FRP(MANUFACTURER STD), BUTT-JOINT, 3.2T |
| STU | 150Ax100A | 1EA | STUB-IN BRANCH |
| RE | 150Ax100A | 1EA | REDUCER ECC, FRP(MANUFACTURER STD), BUTT-JOINT, 3.2T |

<NOTE>
1. (*) FIELD ADJUST

AS BUILT

* PIPE : P/P1 * 90° ELBOW : E90 * 45° ELBOW : E45 * TEE : T * RED.TEE : TR * STUB-IN : STU * REINFORCING PAD : RP * CON.RED : RC * ECC.RED : RE * CON.SWAGE : RCS/RCS1 * ECC.SWAGE : RES/RES1 * NIPPLE : NP/NP1/NP2 * CAP : CAP/CAP1 * PLUG : PLG * FULL COUPLING : FC * HALF COUPLING : HF/HF1
* STUB-IN : STU * SOCKET(HDPE/PVC) : SC * SADDLE(HDPE) : SD * FLANGE : F/F1 * GASKET : G/G1/G2 * BOLT & NUT : B/B1 * BLIND FLANGE : FB/FB1 * GATE VA. : VG/VG1/VG2 * BALL VA. : VB/VBLO/VB1/VB1LO/VB2/VB2LO * BUTTERFLY VA. : VF/VF4 * CHECK VA. : VC/VC1/VC2/VC3/VC4/VC5/VC6/VC7
* GLOBE VA. : VL/VL1/VL2 * DIAPHRAGM VA. : VD/VDLO * DAMPER : VP * QUICK COUPLING : SQC * FLEXIBLE JOINT(STEEL) : FLXB * FLEXIBLE JOINT(RUBBER) : FLXR * FLEXIBLE JOINT(STEEL_EPDM LINED) : FLXL * FLEXIBLE HOSE : FLXH * STEAM TRAP : ST * SPRAY NOZZLE : SPN * EMERGENCY SHOWER : SSH
* STRAINER(Y-TYPE) : YSTR * STRAINER(T-TYPE) : TSTR * STRAINER(BUCKET-TYPE) : BSTR * ANCHOR PLATE : STOP * BIRD SCREEN : BS * ISOLATION KIT : IK * UNLOADING BOX : UB * AIR TRAP : AT * LOTO : LOTO * SIGHT GLASS : SG * PRESSURE GAUGE : PG * SHILED : SH * SPECIAL BOLT & NUT : BL/BL1

| INSULATION | CODE | N |
|---|---|---|
| | THICK. | - |

| CONDITION | PRESS. (kg/cm2g) | TEMP. (°C) |
|---|---|---|
| DESIGN | 1 | AMB |
| OPERATING | ATM | AMB |

AREA W13
UNIT 1FA
REF. PLAN DWG. CJ-M15W13-PI-A30-010007-E
REF. P & ID CJ-M15W13-PR-A20-000031

| REV. NO. | DATE | DESCRIPTION | BY | CHK | APP'D |
|---|---|---|---|---|---|
| 2 | 26.04.30 | AS-BUILT | 황래종 | 안남후 | 박동영 |

CLIENT SK hynix
CONTRACTOR SK ecoplant
PROJECT NAME M15X Ph3 Project
COMMODITY WA
JOB NO. 22330D
LINE NO. 150A-WA-FR1-N-4059
SH'T NO. 02 / 02
REV. 2

경고 : 본 도면은 SK HYNIX의 기업비밀 자료로서, 어떠한 경우에도 목적 외 사용, 복제, 제3자에게 공개, 누설 및 유출할 수 없으며, 회사는 유포자의 불법 사용으로 피해가 발생할 경우 유포자에게 민/형사상 책임을 요구할 수 있음.