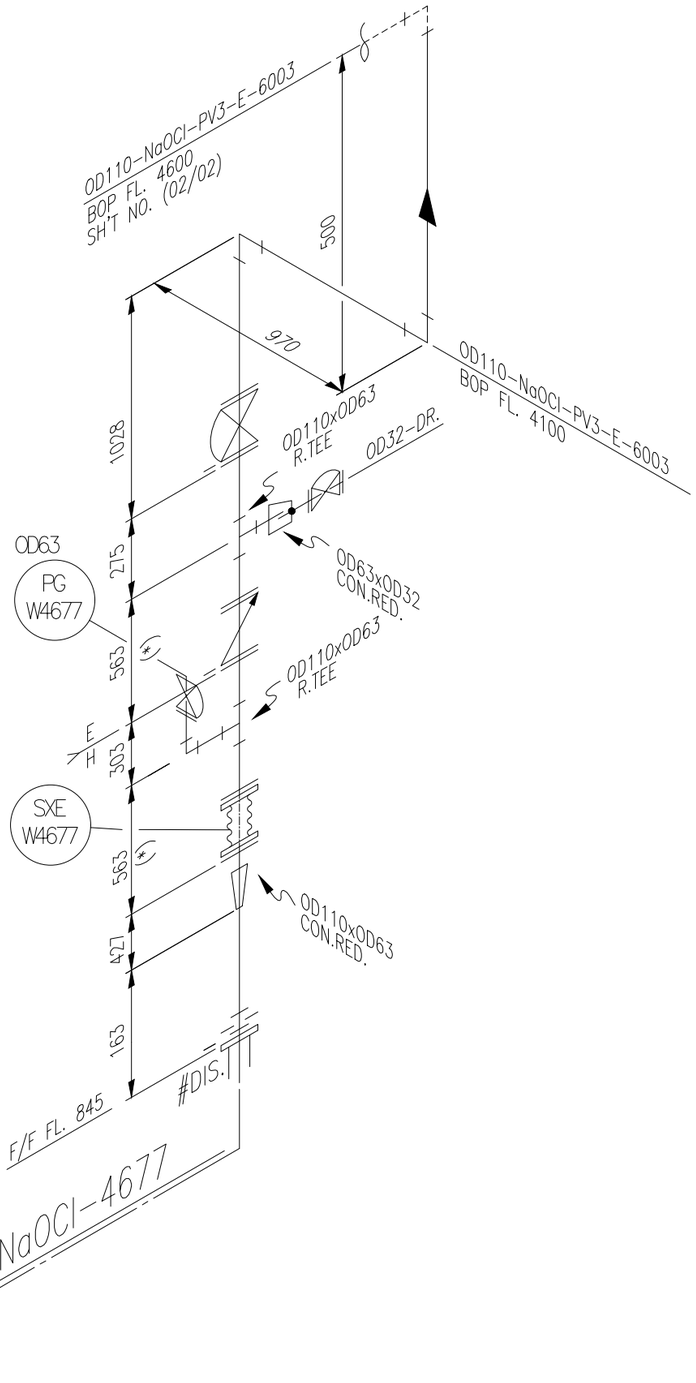


<NOTE>
1. (*) FIELD ADJUST

AS BUILT

ITEM	SIZE	Q'TY	DESCRIPTION
		PV3	
P	OD110	4.5M	PIPE, CPVC, PE, SOCKET FUSION, SDR13.5
P	OD63	0.5M	PIPE, CPVC, PE, SOCKET FUSION, SDR13.5
P	OD32	0.2M	PIPE, CPVC, PE, SOCKET FUSION, SDR13.5
E90	OD110	2EA	ELBOW 90 DEG, CPVC, PE, SOCKET FUSION, SDR13.5
E90	OD63	1EA	ELBOW 90 DEG, CPVC, PE, SOCKET FUSION, SDR13.5
RC	OD110xOD63	2EA	REDUCER CON, CPVC, PE, SOCKET FUSION, SDR13.5
TR	OD110xOD63	1EA	TEE RED, CPVC, PE, SOCKET FUSION, SDR13.5
TR	OD110xOD32	1EA	TEE RED, CPVC, PE, SOCKET FUSION, SDR13.5
VD	OD110	1EA	DIAPHRAGM VALVE, KS 10K, FF FLG'D, BODY-CPVC /
			TRIM-PDDM, BB, HW
VC	OD110	1EA	CHECK VALVE, KS 10K, FF FLG'D, BODY-CPVC /
			TRIM-FPM, BC, SWING
VD	OD63	1EA	DIAPHRAGM VALVE, KS 10K, FF FLG'D, BODY-CPVC /
			TRIM-PDDM, BB, HW
VD	OD32	1EA	DIAPHRAGM VALVE, KS 10K, FF FLG'D, BODY-CPVC /
			TRIM-PDDM, BB, HW
F	OD110	6EA	FLG, KS 10K, FF, STUB FLG CPVC /
			BACKING RING(PP)+INSERT(STEEL), SDR13.5
F	OD63	2EA	FLG, KS 10K, FF, STUB FLG CPVC /
			BACKING RING(PP)+INSERT(STEEL), SDR13.5
F	OD32	1EA	FLG, KS 10K, FF, STUB FLG CPVC /
			BACKING RING(PP)+INSERT(STEEL), SDR13.5
FB	OD32	1EA	FLG BLIND, KS 10K, FF, CPVC, SDR13.5
G	OD110	6EA	GASKET, KS 10K, FF, PTFE+EPDM, 3.0MM TH'K
G	OD63	2EA	GASKET, KS 10K, FF, PTFE+EPDM, 3.0MM TH'K
G	OD32	2EA	GASKET, KS 10K, FF, PTFE+EPDM, 3.0MM TH'K
B	OD110	6SET	MACHINE BOLT & NYLON NUT :STS 304 / W WASHERS
B	OD63	2SET	MACHINE BOLT & NYLON NUT :STS 304 / W WASHERS
B	OD32	2SET	MACHINE BOLT & NYLON NUT :STS 304 / W WASHERS
FLXR	OD110	1EA	FLEXIBLE JOINT(TPC RUBBER TYPE)
SH	OD110	6EA	SHIELD
SH	OD63	2EA	SHIELD
SH	OD32	2EA	SHIELD
PG	OD63	1EA	PRESSURE GAUGE, KS 10K, FF
IN	25tXOD110	4.5M	관 보온재(고무발포)
IN	25tXOD32	0.7M	관 보온재(고무발포)
IN	75tXOD63	1.2M	관 보온재(GLASS WOOL)
IN	50tXOD63	0.5M	관 보온재(GLASS WOOL)

* PIPE : P/P1 * 90° ELBOW : E90 * 45° ELBOW : E45 * TEE : T * RED.TEE : TR * STUB-IN : STU * REINFORCING PAD : RP * CON.RED : RC * ECC.RED : RE * CON.SWAGE : RCS/RCS1 * ECC.SWAGE : RES/RES1 * NIPPLE : NP/NP1/NP2 * CAP : CAP/CAP1 * PLUG : PLG * FULL COUPLING : FC * HALF COUPLING : HF/HF1
* STUB-IN : STU * SOCKET(HDPE/PVC) : SC * SADDLE(HDPE) : SD * FLANGE : F/F1 * GASKET : G/G1/G2 * BOLT & NUT : B/B1 * BLIND FLANGE : FB/FB1 * GATE VA. : VG/VG1/VG2 * BALL VA. : VB/VBLO/VB1/VB1LO/VB2/VB2LO * BUTTERFLY VA. : VF/VF4 * CHECK VA. : VC/VC1/VC2/VC3/VC4/VC5/VC6/VC7
* GLOBE VA. : VL/VL1/VL2 * DIAPHRAGM VA. : VD/VDLO * DAMPER : VP * QUICK COUPLING : SQC * FLEXIBLE JOINT(STEEL) : FLXB * FLEXIBLE JOINT(RUBBER) : FLXR * FLEXIBLE JOINT(STEEL_PTFE LINED) : FLXL * FLEXIBLE HOSE : FLXH * STEAM TRAP : ST * SPRAY NOZZLE : SPN * EMERGENCY SHOWER : SSH
* STRAINER(Y-TYPE) : YSTR * STRAINER(T-TYPE) : TSTR * STRAINER(BUCKET-TYPE) : BSTR * ANCHOR PLATE : STOP * BIRD SCREEN : BS * ISOLATION KIT : IK * UNLOADING BOX : UB * AIR TRAP : AT * LOTO : LOTO * SIGHT GLASS : SG * PRESSURE GAUGE : PG * SHILED : SH * SPECIAL BOLT & NUT : BL/BL1

INSULATION	CODE	E
	THICK.	25

CONDITION	PRESS. (kg/cm2g)	TEMP. (°C)
DESIGN	1	60
OPERATING	ATM	AMB

AREA W13
UNIT 1FA
REF. PLAN DWG. CJ-M15W13-PI-A30-010006-A
REF. P & ID CJ-M15W13-PR-A20-000061

REV. NO.	DATE	DESCRIPTION	BY	CHK	APP'D
	26.04.30	AS-BUILT	황래종	안남후	박동영

CLIENT SK hynix

CONTRACTOR SK ecoplant

PROJECT NAME: M15X Ph3 Project

COMMODITY: NaOCl

JOB NO.: 22330D

LINE NO.: 0D110-NaOCl-PV3-E-6003

SH'T NO.: 01 / 02

REV.:

경고 : 본 도면은 SK HYNIX의 기업비밀 자료로서, 어떠한 경우에도 목적 외 사용, 복제, 제3자에게 공개, 누설 및 유출할 수 없으며, 회사는 유포자의 불법 사용으로 피해가 발생할 경우 유포자에게 민/형사상 책임을 요구할 수 있음.