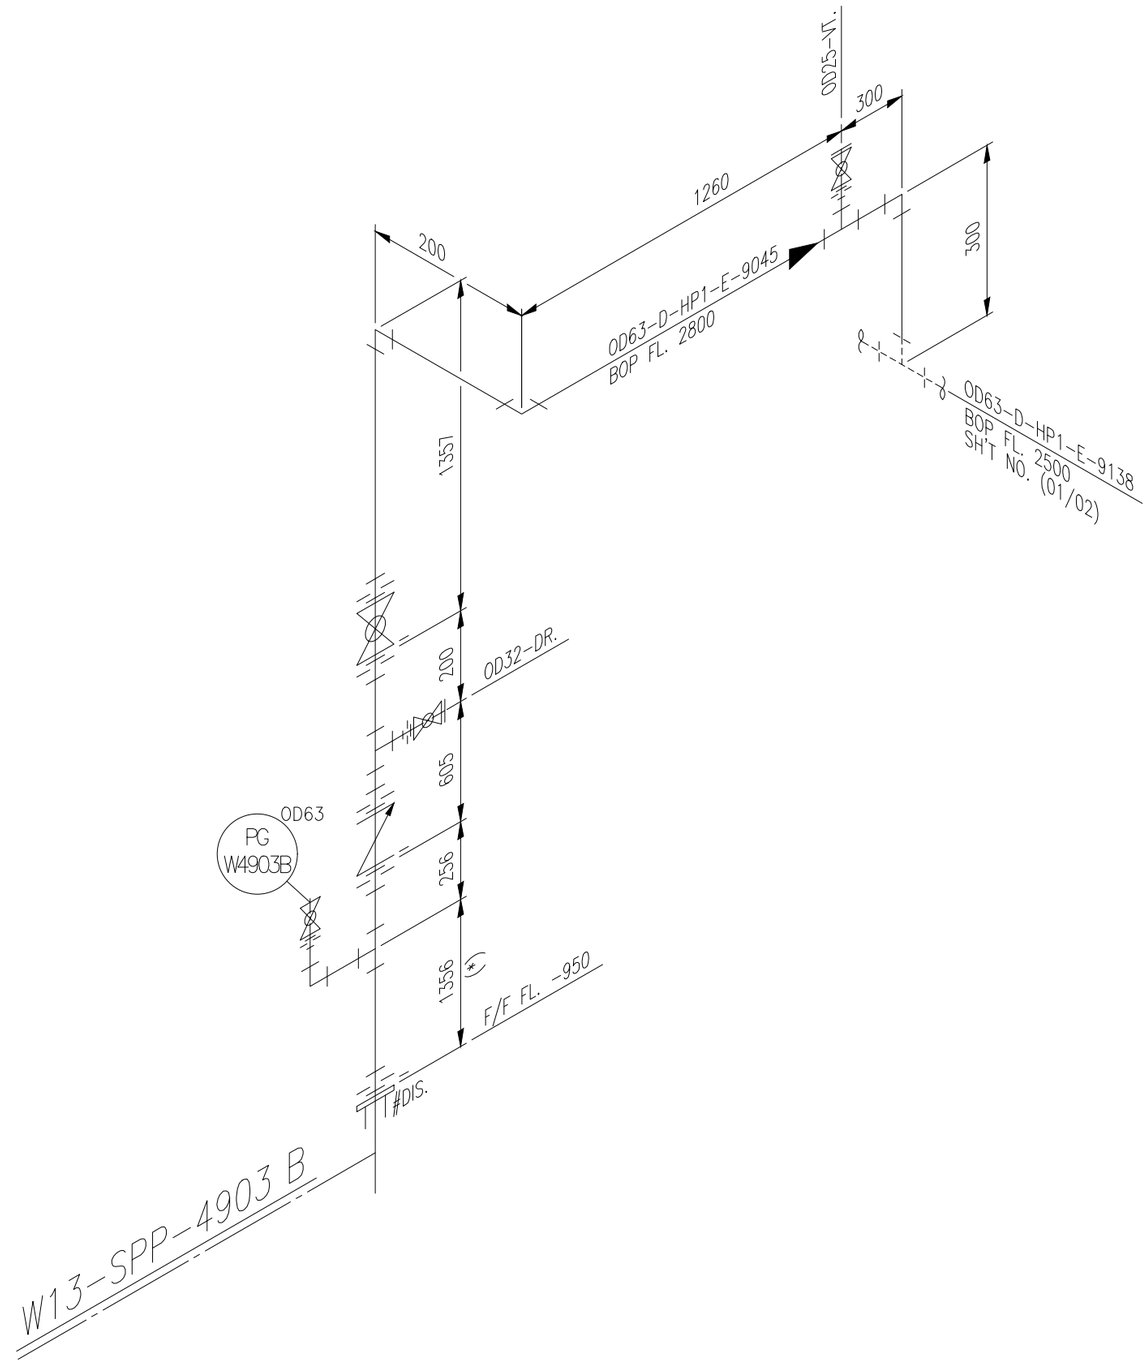


<NOTE>
1. (*) FIELD ADJUST

AS BUILT

ITEM	SIZE	Q'TY	DESCRIPTION
		HP1	
P	OD63	5.9M	PIPE, HDPE PE100, PE, SOCKET FUSION, PN16/SDR11
P	OD32	0.1M	PIPE, HDPE PE100, PE, SOCKET FUSION, PN16/SDR11
P	OD25	0.1M	PIPE, HDPE PE100, PE, SOCKET FUSION, PN16/SDR11
E90	OD63	4EA	ELBOW 90 DEG, HDPE PE100, PE, SOCKET FUSION,
			PN16/SDR11
T	OD63	1EA	TEE EQUAL, HDPE PE100, PE, SOCKET FUSION, PN16/SDR11
TR	OD63xOD32	1EA	TEE RED, HDPE PE100, PE, SOCKET FUSION, PN16/SDR11
TR	OD63xOD25	1EA	TEE RED, HDPE PE100, PE, SOCKET FUSION, PN16/SDR11
VB	OD32	1EA	BALL VALVE, KS 10K, FF FLG'D, BODY-PP /
			TRIM-PP / SEAT-PTFE, FB, LEVER
VB	OD25	1EA	BALL VALVE, KS 10K, FF FLG'D, BODY-PP /
			TRIM-PP / SEAT-PTFE, FB, LEVER
VB	OD63	2EA	BALL VALVE, KS 10K, FF FLG'D, BODY-PP /
			TRIM-PP / SEAT-PTFE, FB, LEVER
VC	OD63	1EA	CHECK VALVE, KS 10K, FF FLG'D, BODY-PP
			/ TRIM-PP, BC, SWING
F	OD63	6EA	FLG LAP JOINT / STUB END SET, KS 10K, FF,
			LAP JOINT-STS304 / STUB END-HDPE PE100
F	OD32	1EA	FLG LAP JOINT / STUB END SET, KS 10K, FF,
			LAP JOINT-STS304 / STUB END-HDPE PE100
F	OD25	1EA	FLG LAP JOINT / STUB END SET, KS 10K, FF,
			LAP JOINT-STS304 / STUB END-HDPE PE100
FB	OD32	1EA	FLG BLIND & LINER SET, KS 10K, FF, BLIND-STS304
			/ LINDER-HDPE PE100 (MIN 5.0MM TH'K)
FB	OD25	1EA	FLG BLIND & LINER SET, KS 10K, FF, BLIND-STS304
			/ LINDER-HDPE PE100 (MIN 5.0MM TH'K)
G	OD63	6EA	GASKET, KS 10K, FF, PTFE+EPDM, 3.0MM TH'K
G	OD32	1EA	GASKET, KS 10K, FF, PTFE+EPDM, 3.0MM TH'K
G	OD25	1EA	GASKET, KS 10K, FF, PTFE+EPDM, 3.0MM TH'K
G2	OD32	1EA	GASKET, KS 10K, FF, PTFE+EPDM, BLIND, 3.0MM TH'K
G2	OD25	1EA	GASKET, KS 10K, FF, PTFE+EPDM, BLIND, 3.0MM TH'K
B	OD63	6SET	MACHINE BOLT & NUTS :STS 304 / W WASHERS
B	OD32	2SET	MACHINE BOLT & NUTS :STS 304 / W WASHERS
B	OD25	2SET	MACHINE BOLT & NUTS :STS 304 / W WASHERS
PG	OD63	1EA	PRESSURE GAUGE, KS 10K, FF
IN	25tX50A	6.0M	관 보온재(고무발포)
IN	25tX25A	0.6M	관 보온재(고무발포)
IN	25tX20A	0.3M	관 보온재(고무발포)

* PIPE : P/P1 * 90° ELBOW : E90 * 45° ELBOW : E45 * TEE : T * RED.TEE : TR * STUB-IN : STU * REINFORCING PAD : RP * CON.RED : RC * ECC.RED : RE * CON.SWAGE : RCS/RCS1 * ECC.SWAGE : RES/RES1 * NIPPLE : NP/NP1/NP2 * CAP : CAP/CAP1 * PLUG : PLG * FULL COUPLING : FC * HALF COUPLING : HF/HF1
* STUB-IN : STU * SOCKET(HDPE/PVC) : SC * SADDLE(HDPE) : SD * FLANGE : F/F1 * GASKET : G/G1/G2 * BOLT & NUT : B/B1 * BLIND FLANGE : FB/FB1 * GATE VA. : VG/VG1/VG2 * BALL VA. : VB/VBLO/VB1/VB1LO/VB2/VB2LO * BUTTERFLY VA. : VF/VF4 * CHECK VA. : VC/VC1/VC2/VC3/VC4/VC5/VC6/VC7
* GLOBE VA. : VL/VL1/VL2 * DIAPHRAGM VA. : VD/VDLO * DAMPER : VP * QUICK COUPLING : SQC * FLEXIBLE JOINT(STEEL) : FLXB * FLEXIBLE JOINT(RUBBER) : FLXR * FLEXIBLE JOINT(STEEL_PTFE LINED) : FLXL * FLEXIBLE HOSE : FLXH * STEAM TRAP : ST * SPRAY NOZZLE : SPN * EMERGENCY SHOWER : SSH
* STRAINER(Y-TYPE) : YSTR * STRAINER(T-TYPE) : TSTR * STRAINER(BUCKET-TYPE) : BSTR * ANCHOR PLATE : STOP * BIRD SCREEN : BS * ISOLATION KIT : IK * UNLOADING BOX : UB * AIR TRAP : AT * LOTO : LOTO * SIGHT GLASS : SG * PRESSURE GAUGE : PG * SHILED : SH * SPECIAL BOLT & NUT : BL/BL1

INSULATION	CODE	E
	THICK.	25

CONDITION	PRESS. (kg/cm2g)	TEMP. (°C)
DESIGN	TBD	60
OPERATING	3	AMB

AREA W13
UNIT 1FA
REF. PLAN DWG. CJ-M15W13-PI-A30-010006-A
REF. P & ID CJ-M15W13-PR-A20-000061

REV. NO.	DATE	DESCRIPTION	BY	CHK	APP'D
	26.04.30	AS-BUILT	황래종	안남후	박동영

CLIENT SK hynix

CONTRACTOR SK ecoplant

PROJECT NAME M15X Ph3 Project

COMMODITY D

JOB NO. 22330D

LINE NO. G OD63-D-HP1-E-9045

SH'T NO. 01 / 01

REV.

경고 : 본 도면은 SK HYNIX의 기업비밀 자료로서, 어떠한 경우에도 목적 외 사용, 복제, 제3자에게 공개, 누설 및 유출할 수 없으며, 회사는 유포자의 불법 사용으로 피해가 발생할 경우 유포자에게 민/형사상 책임을 요구할 수 있음.